


A1

306031 Redacted

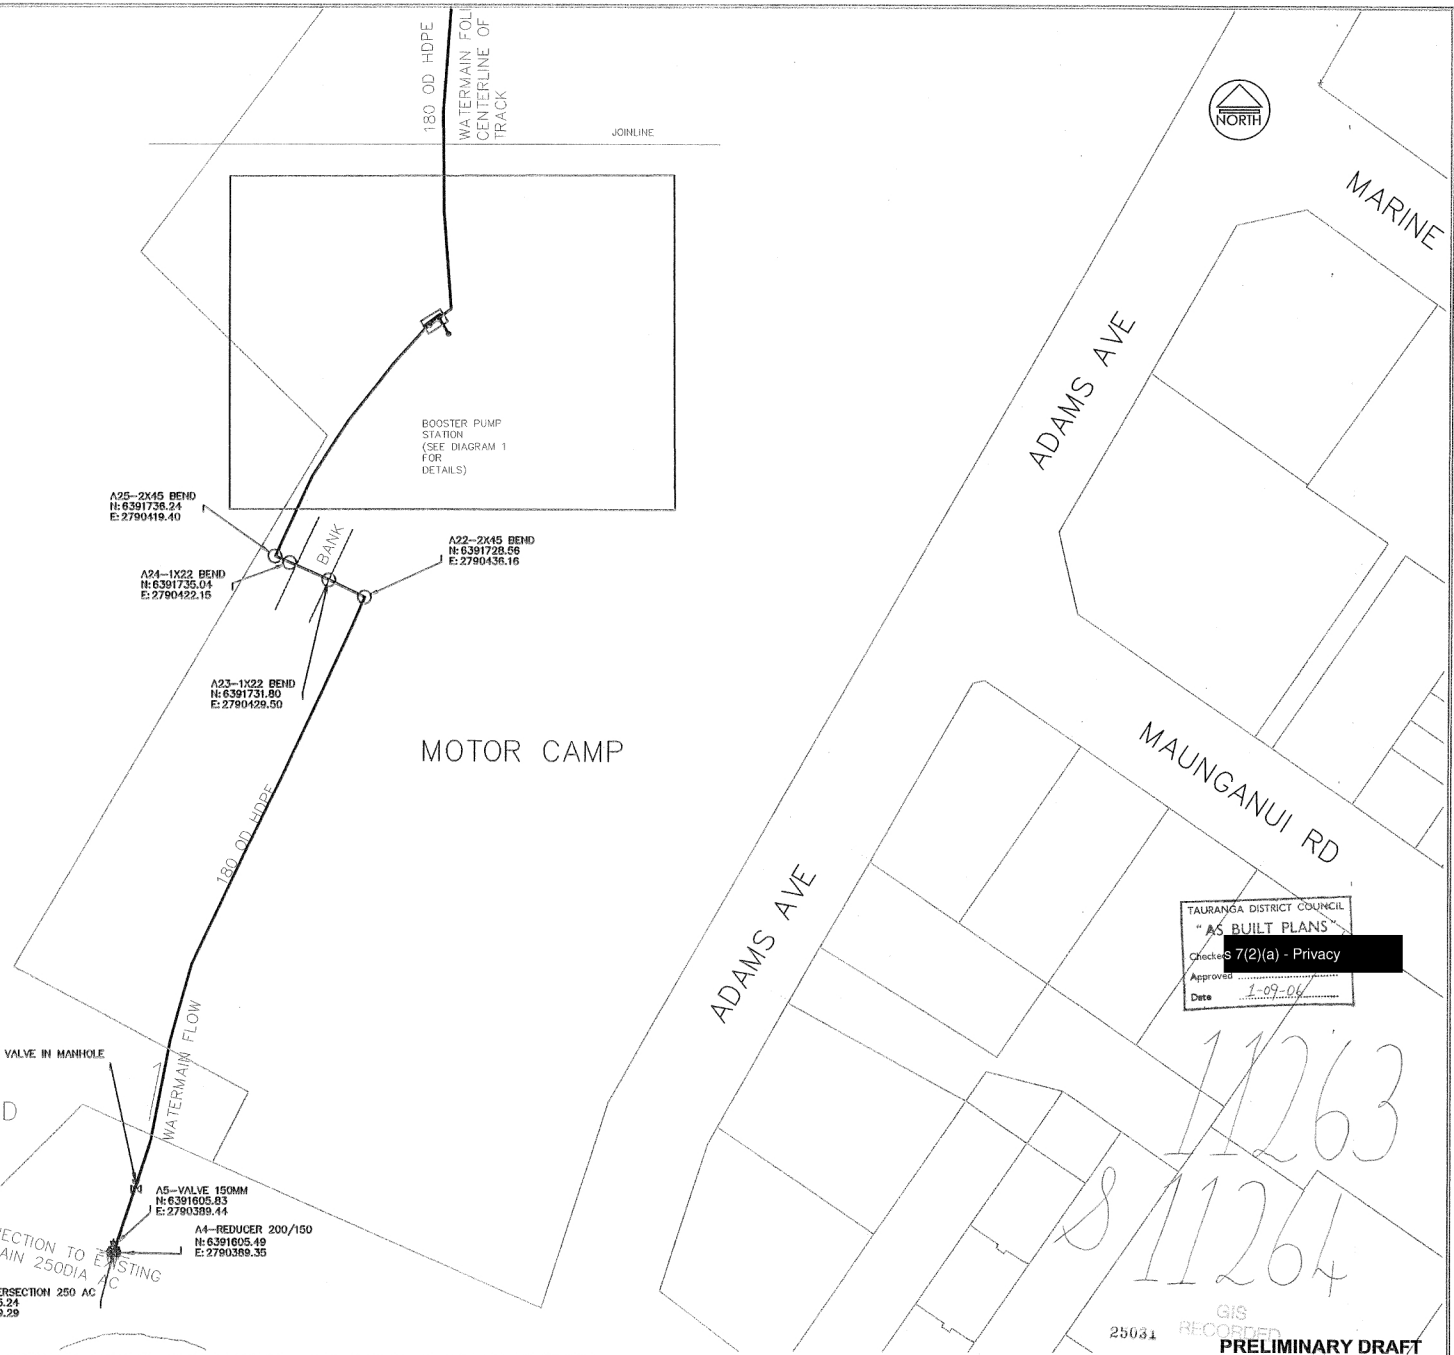

NOTES
 CO-ORDINATES ARE IN TERMS OF NZ MAP GRID
 NEW WATERMAIN IS 180mm OD HDPE
 CLASS-PN16
 TYPE-PE100SDR11
 ALL VALVE FITTINGS AVK
 ALL FITTINGS MANUFACTURED-TYCO
 INSTALL DATES- 10/2005 TO 11/2005

TAURANGA DISTRICT COUNCIL
 "AS BUILT PLANS"
 Checked 7(2)(a) - Privacy
 Approved
 Date 1-09-04

25031 GIS RECORDER
PRELIMINARY DRAFT



	Name	Date
SURVEYED	AM	
DESIGNED		
DRAWN		
CHECKED		
APPROVED		

MAUAO
 FIRE FIGHTING WATER MAIN AS BUILT
 TAURANGA CITY COUNCIL

Status Stamp	Date Stamp	Scale	Sheet No.	Rev.
PRELIMINARY DRAFT	16/01/06	SCALES (A1) 1:500	303523	2