


A1

306032 Redacted

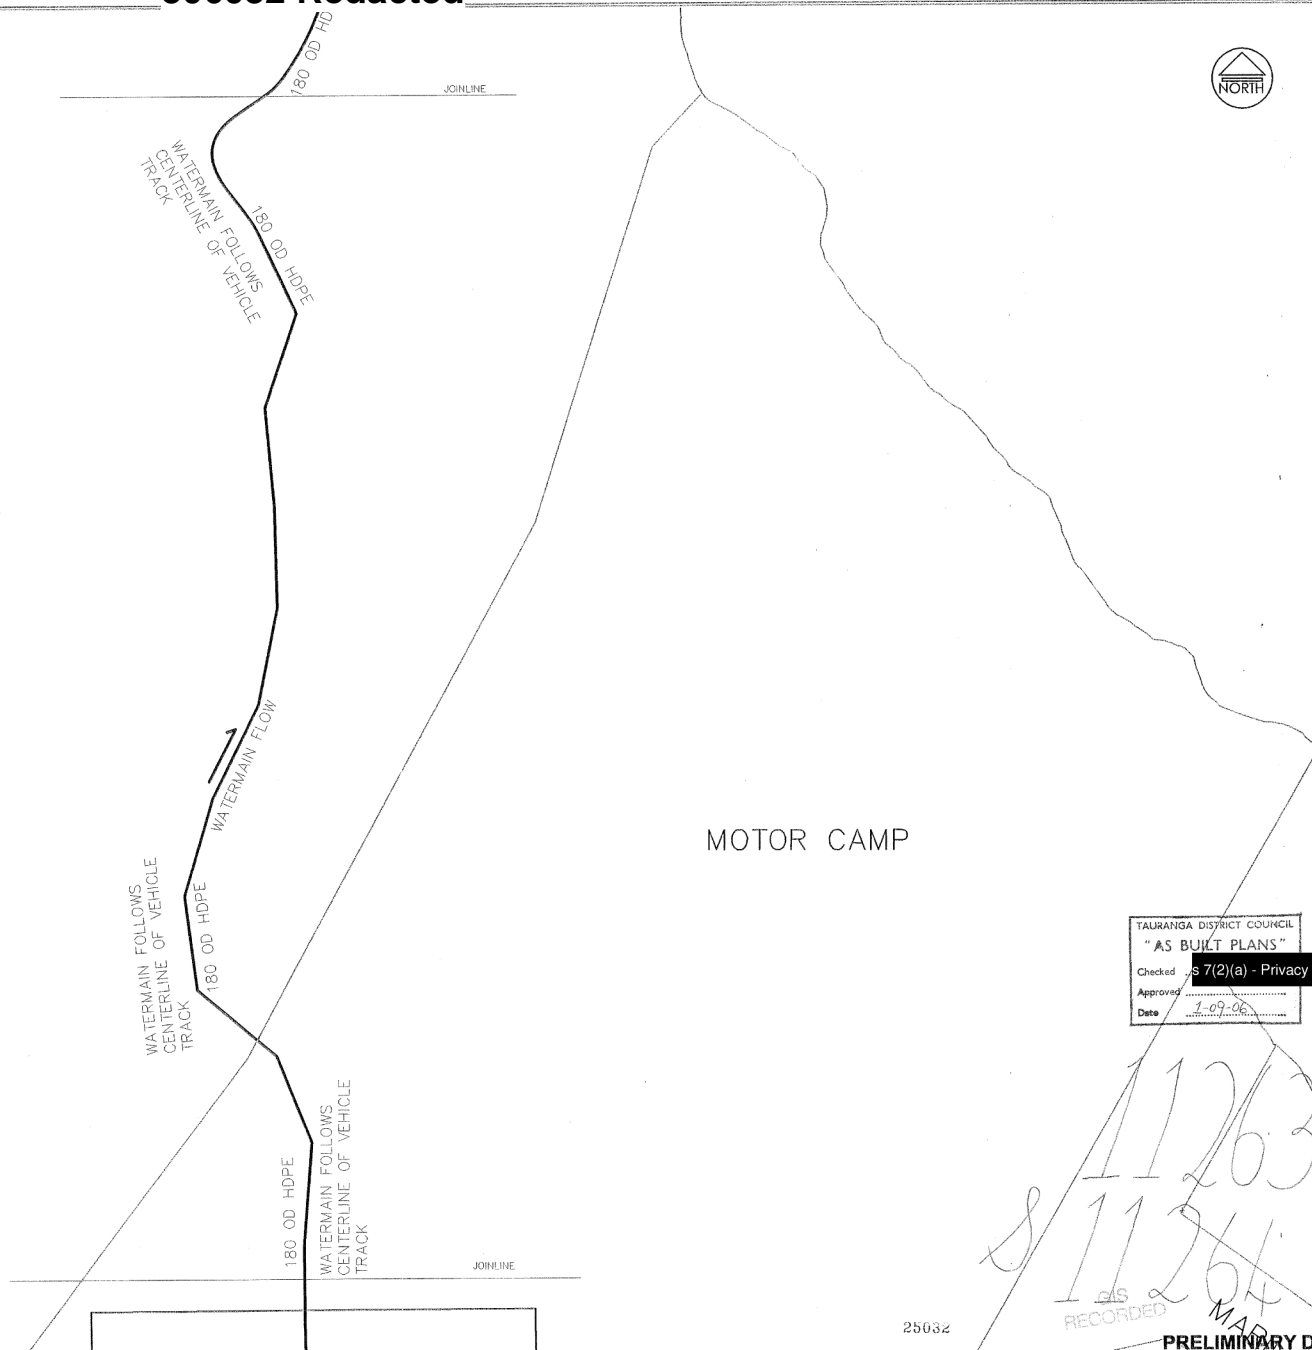

NOTES  
 CO-ORDINATES ARE IN TERMS OF NZ MAP GRID  
 NEW WATERMAIN IS 180mm OD HDPE  
 CLASS-PN16  
 TYPE-PE100SDR11  
 ALL VALVE FITTINGS AVK  
 ALL FITTINGS MANUFACTURED-TYCO  
 INSTALL DATES- 10/2005 TO 11/2005

TAURANGA DISTRICT COUNCIL  
 "AS BUILT PLANS"  
 Checked: S 7(2)(a) - Privacy  
 Approved: [Redacted]  
 Date: 1-09-06

Handwritten notes: S 11 263, 264, 265, 999, 1000.

|          | Name | Date |
|----------|------|------|
| SURVEYED | JM   |      |
| DESIGNED |      |      |
| DRAWN    |      |      |
| CHECKED  |      |      |
| APPROVED |      |      |

MAUAO  
 FIRE FIGHTING WATER MAIN AS BUILT  
 TAURANGA CITY COUNCIL

|                    |                          |
|--------------------|--------------------------|
| Signature Stamp    | <b>PRELIMINARY DRAFT</b> |
| Date Stamp         | 16/01/06                 |
| SCALES (A1): 1:500 | Sheet No. 3              |
| Job No. 303523     | Rev.                     |

**Fulton Hogan Ltd**  
 Bay of Plenty