


A1

306033 Redacted

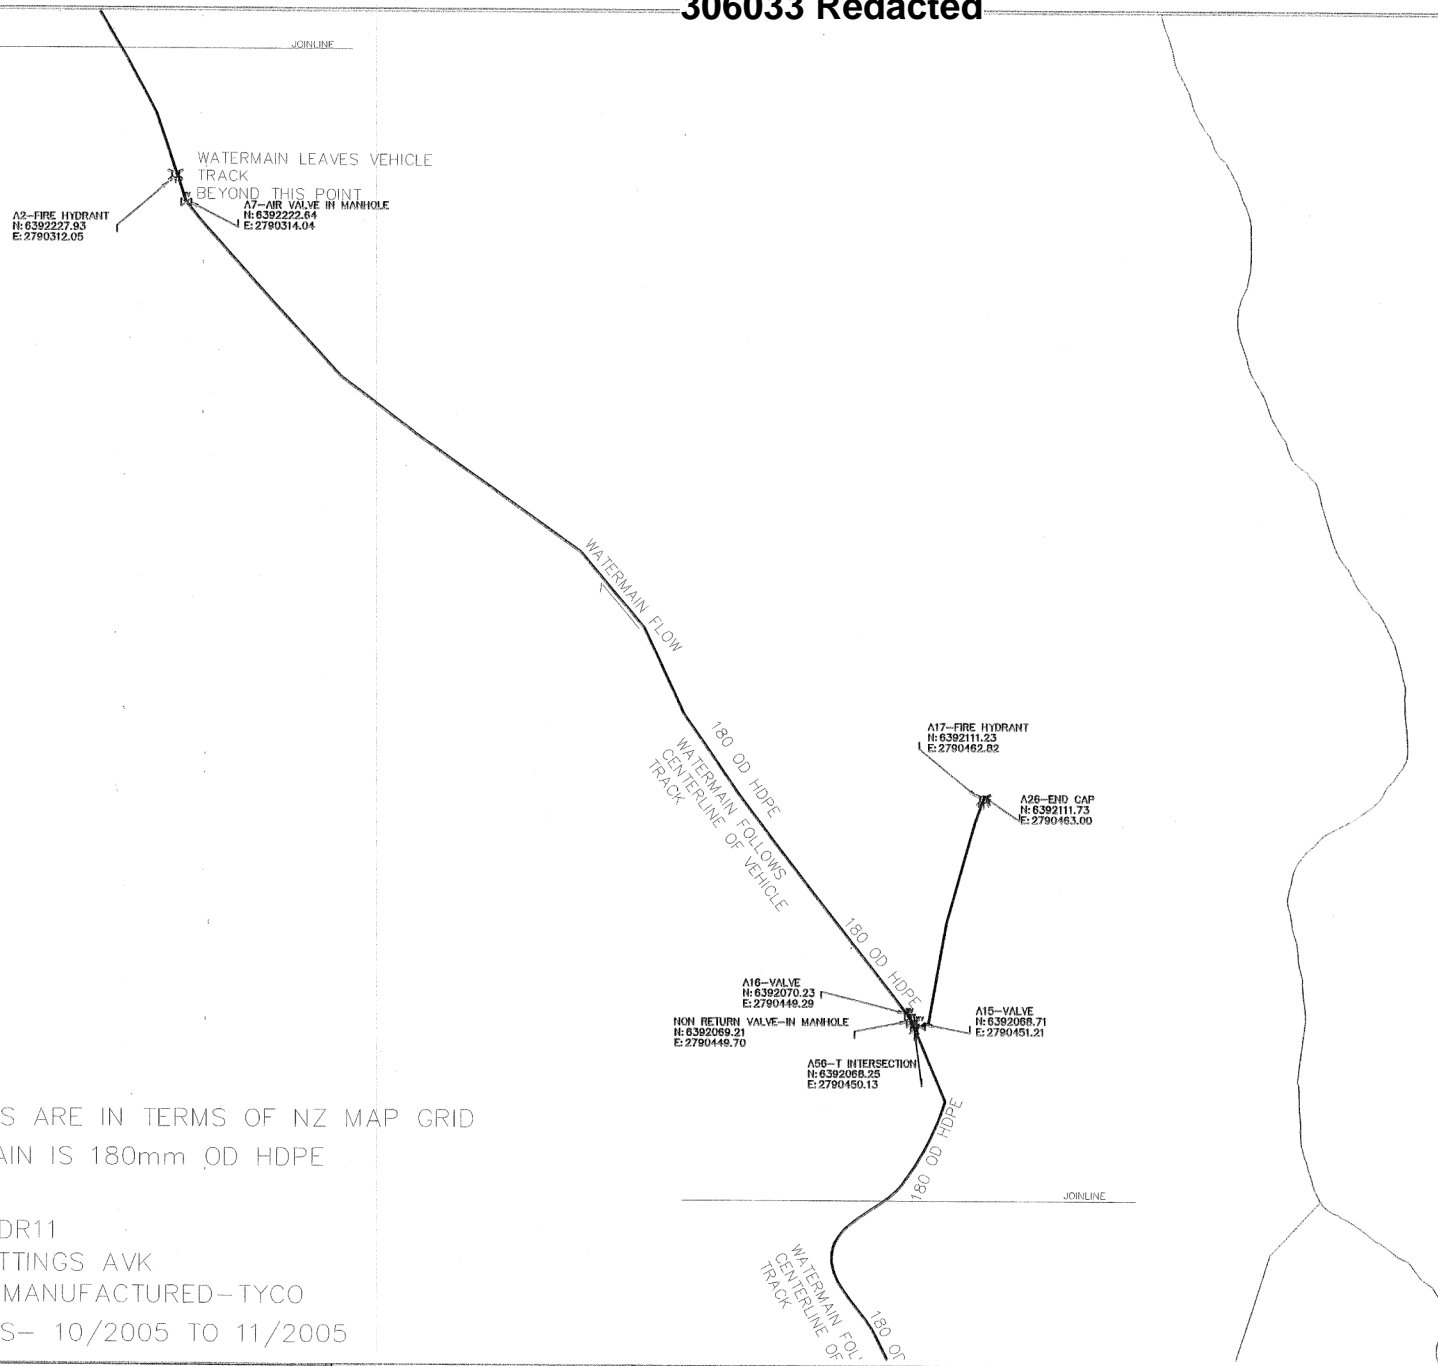

NOTES

CO-ORDINATES ARE IN TERMS OF NZ MAP GRID
 NEW WATERMAIN IS 180mm OD HDPE
 CLASS-PN16
 TYPE-PE100SDR11
 ALL VALVE FITTINGS AVK
 ALL FITTINGS MANUFACTURED-TYCO
 INSTALL DATES- 10/2005 TO 11/2005

TAURANGA DISTRICT COUNCIL
 "AS BUILT PLANS"
 Checked by 7(2)(a) - Privacy
 Approved
 Date 1-09-06

11263
 11264
 GIS RECORDED

25033 PRELIMINARY DRAFT

Fulton Hogan Ltd
 Bay of Plenty

	Name	Date
SURVEYED	JM	
DESIGNED		
DRAWN		
CHECKED		
APPROVED		

MAUAO
 FIRE FIGHTING WATER MAIN AS BUILT
 TAURANGA CITY COUNCIL

Scale Stamp	PRELIMINARY DRAFT		
Date Stamp	16/01/06		
SCALES (A1) 1:500	Sheet No.	Rev.	
303523	4		